

STATE ENGINEER  
Salem, Oregon

LINN  
7056

# Well Record

STATE WELL NO. 11/3W-2E  
COUNTY Linn  
APPLICATION NO. GR-3891

OWNER: John Kohlnhofer


MAILING ADDRESS: Route 2, Box 462

LOCATION OF WELL: Owner's No.

CITY AND STATE: Albany, Oregon

SW 1/4 NW 1/4 Sec. 2 T. 11 S., R. 3 W., W.M.

Bearing and distance from section or subdivision corner 3102' S. & 198' E. of NW cor. Sec. 2

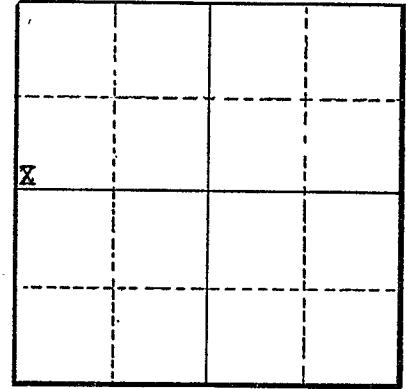

Section 2

Altitude at well

TYPE OF WELL: Drilled Date Constructed 1951

Depth drilled 40 feet Depth cased

### CASING RECORD:

8 inch steel casing set to unknown depth

### FINISH:

### AQUIFERS:

### WATER LEVEL:

PUMPING EQUIPMENT: Type Sears Roebuck centrifugal H.P. 2  
Capacity G.P.M.

### WELL TESTS:

Drawdown ft. after hours G.P.M.

Drawdown ft. after hours G.P.M.

USE OF WATER Irrigation Temp. °F., 19

SOURCE OF INFORMATION Well Registration Statement Cert. # GR-3535

DRILLER or DIGGER

### ADDITIONAL DATA:

Log Water Level Measurements Chemical Analysis Aquifer Test

### REMARKS: