

STATE ENGINEER
Salem, Oregon

LINN
1057

Well Record

STATE WELL NO. 11/3W-2H
COUNTY Linn
APPLICATION NO. GR-3890


OWNER: Milford G. Kennell

MAILING ADDRESS: Route 2, Box 464

LOCATION OF WELL: Owner's No.

CITY AND STATE: Albany, Oregon

SE 1/4 NE 1/4 Sec. 2 T. 11 S., R. 3 W., W.M.

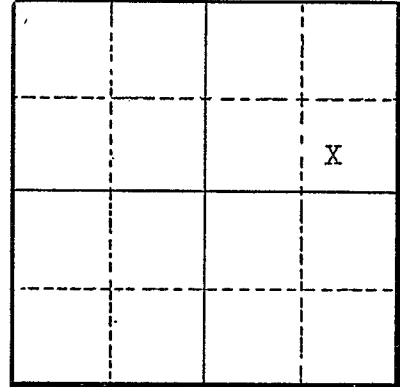

Bearing and distance from section or subdivision corner 1914' S. & 1056' W. of NE cor. Sec. 2

Section 2

Altitude at well

TYPE OF WELL: Drilled Date Constructed July, 1955

Depth drilled 97 feet Depth cased 27 feet

CASING RECORD:

10 inch steel casing set to 27 feet

FINISH:

Slot perforations from 13 to 27 feet

AQUIFERS:

WATER LEVEL:

6 feet below surface

PUMPING EQUIPMENT: Type Jacuzzi centrifugal H.P. 7 1/2
Capacity 180 G.P.M.

WELL TESTS:

Drawdown ft. after hours G.P.M.
Drawdown ft. after hours G.P.M.

USE OF WATER Irrigation Temp. °F., 19

SOURCE OF INFORMATION Well Registration Statement Cert. # GR-3534

DRILLER or DIGGER Bill Hamilton

ADDITIONAL DATA:

Log Water Level Measurements Chemical Analysis Aquifer Test

REMARKS: