

STATE ENGINEER
Salem, Oregon

LINN
7088


Well Record

STATE WELL NO. 11/3W-3D
COUNTY LINN
APPLICATION NO. GR-2873

OWNER: Enos and Mildred Noah
MAILING ADDRESS: 425 N. Clover Ridge Road
CITY AND STATE: Albany, Oregon

LOCATION OF WELL: Owner's No. NW 1/4 NW 1/4 Sec. 3 T. 11 S., R. 3 W., W.M.

Bearing and distance from section or subdivision corner S. 45° 30' W. 18.2 chains from NE cor. of DLC 38.

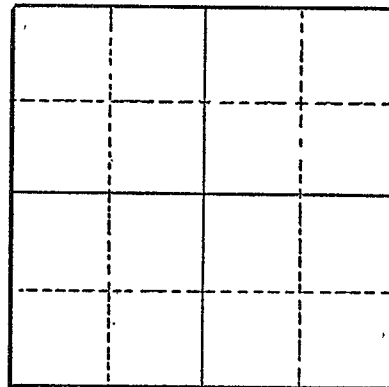

Section

Altitude at well

TYPE OF WELL: drilled Date Constructed 1954

Depth drilled 91 Depth cased 91

CASING RECORD:

8-inch

FINISH:

Slot perforations from 71 to 91

AQUIFERS:

WATER LEVEL:
4-feet

PUMPING EQUIPMENT: Type Peerless Deep well turbine H.P. 5
Capacity 150 G.P.M.

WELL TESTS:
Drawdown 63 ft. after Pumping 100 hours G.P.M.
Drawdown ft. after hours G.P.M.

USE OF WATER irrigation Temp. °F. 19

SOURCE OF INFORMATION GR-2707

DRILLER or DIGGER Nicholas Klaus, Rt. 4, Albany, Oregon

ADDITIONAL DATA:

Log Water Level Measurements Chemical Analysis Aquifer Test

REMARKS: