

STATE ENGINEER
Salem, Oregon

LINN
7145

Well Record

STATE WELL NO. 11/3W-4C
COUNTY Linn
APPLICATION NO. GR-3236

OWNER: Roy and Ruth E. Snoderly

MAILING ADDRESS: 1060 N. Highway 99

LOCATION OF WELL: Owner's No. _____


CITY AND STATE: Albany, Oregon

NE 1/4 NW 1/4 Sec. 4 T. 11 S., R. 3 W., W.M.

Bearing and distance from section or subdivision

165' S. and 2178' E. of the N.W. corner

Section 4

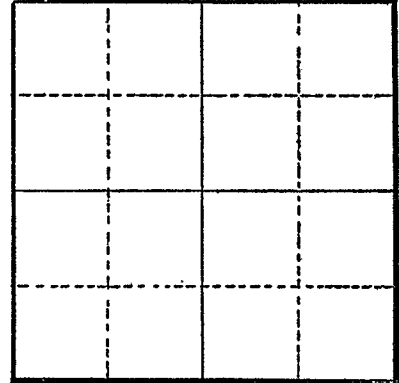

Section _____

Altitude at well _____

TYPE OF WELL: drilled Date Constructed 1947

Depth drilled 90 Depth cased 90

CASING RECORD:

8 inch

FINISH:

AQUIFERS:

WATER LEVEL:

5 feet

PUMPING EQUIPMENT: Type Weinman centrifugal

H.P. 4 1/2

Capacity 50 G.P.M.

WELL TESTS:

Drawdown _____ ft. after _____ hours _____ G.P.M.

Drawdown _____ ft. after _____ hours _____ G.P.M.

USE OF WATER Irrigation Temp. _____ °F., 19 _____

SOURCE OF INFORMATION GR-3013

DRILLER or DIGGER Willard Sloper, Albany, Oregon

ADDITIONAL DATA:

Log _____ Water Level Measurements _____ Chemical Analysis _____ Aquifer Test _____

REMARKS: