

STATE ENGINEER
Salem, Oregon

LINN
7/67

Well Record

STATE WELL NO. 11/3W-5J
COUNTY Linn
APPLICATION NO. GR-1623

GR- 1581

OWNER: D. E. Nebergall Meat Co.


MAILING ADDRESS: Box 188

LOCATION OF WELL: Owner's No. #1

CITY AND STATE: Albany, Oregon

NE 1/4 SE 1/4 Sec. 5 T. 11 N. S., R. 3 W., W.M.

Bearing and distance from section or subdivision corner 525' E. & 145' S. from NW cor. of NE 1/4 SE 1/4 of Section 5

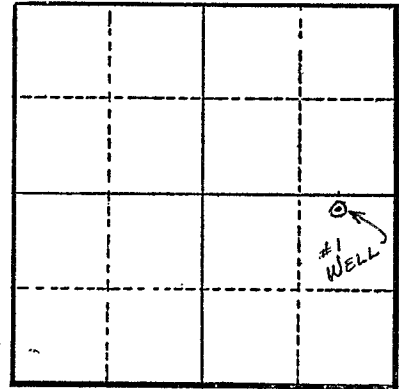

Section 5

Altitude at well 200'

TYPE OF WELL: Drilled Date Constructed 1936

Depth drilled 96' Depth cased 96'

CASING RECORD:

8"

FINISH:

Slot perforations from 78 to 96 ft.

AQUIFERS:

WATER LEVEL:

18'

PUMPING EQUIPMENT: Type Deep Well Turbine H.P. 7 1/2

Capacity 75 G.P.M.

WELL TESTS:

Drawdown 60 ft. after 125 hours G.P.M.

Drawdown ft. after hours G.P.M.

USE OF WATER Industrial Temp. °F., 19

SOURCE OF INFORMATION GR Record

DRILLER or DIGGER

ADDITIONAL DATA:

Log Water Level Measurements Chemical Analysis Aquifer Test

REMARKS:

Log: Clay	0 to 10 ft.
Clay & gravel	10 to 42 ft.
Sand & gravel	42 to 70 ft.
Shale	70 to 86 ft.
Black sand	86 to 96 ft.

~~XXXXXXXXXXXX~~