

STATE ENGINEER  
Salem, Oregon

LINN  
7168

# Well Record

STATE WELL NO. 11/3W-5J  
COUNTY Linn  
APPLICATION NO. GR-1624

GR- 1582

OWNER: D. E. Nebergall Meat Co.


MAILING ADDRESS: Box 188

LOCATION OF WELL: Owner's No. #2

CITY AND STATE: Albany, Oregon

NE 1/4 SE 1/4 Sec. 5 T. 11 N. S, R. 3 W., W.M.

Bearing and distance from section or subdivision corner S. 8°40' E. 530' from NW cor. DIC. #49

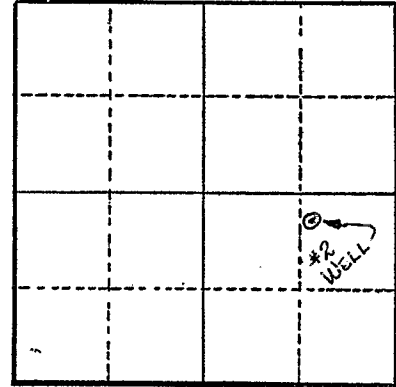

Section 5

Altitude at well 200'

TYPE OF WELL: Drilled Date Constructed 1944

Depth drilled 106' Depth cased 106'

### CASING RECORD:

10"

### FINISH:

Slot perforations from 94 to 106 ft.

### AQUIFERS:

### WATER LEVEL:

32'

PUMPING EQUIPMENT: Type Deep Well Turbine H.P. 2

Capacity 50 G.P.M.

### WELL TESTS:

Drawdown 80 ft. after 60 hours G.P.M.

Drawdown ft. after hours G.P.M.

USE OF WATER Industrial Temp. °F. 19

SOURCE OF INFORMATION GR Record

DRILLER or DIGGER

### ADDITIONAL DATA:

Log Water Level Measurements Chemical Analysis Aquifer Test

### REMARKS:

Log: Soil & clay 0 to 16 ft.  
Clay & gravel 16 to 55 ft.  
Sand & gravel 55 to 85 ft.  
Brown sand & gravel 85 to 106 ft.

~~XXXXXXXXXXXX~~