

STATE ENGINEER  
Salem, Oregon

LINN  
7217

# Well Record

STATE WELL NO. 11/3W-8K  
COUNTY LINN  
APPLICATION NO. GR-2528

OWNER: Marvel L. & Opal G. Cooley


MAILING ADDRESS: 2105 E. Queen Avenue

LOCATION OF WELL: Owner's No.

CITY AND STATE: Albany, Oregon

NW 1/4 SE 1/4 Sec. 8 T. 11 S. R. 3 W., W.M.

Bearing and distance from section or subdivision corner 2035' N. & 2244' W.

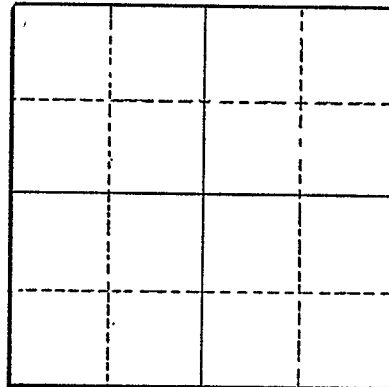

Section

Altitude at well

TYPE OF WELL: Drilled Date Constructed 1949

Depth drilled 89 Depth cased 75

### CASING RECORD:

8-inch

### FINISH:

Slot perforations from 77 to 89

### AQUIFERS:

Clay, conglomerate, gravel and sand

### WATER LEVEL:

35-feet

PUMPING EQUIPMENT: Type Berkeley Jet H.P. 2  
Capacity 50 G.P.M.

### WELL TESTS:

Drawdown ft. after hours G.P.M.  
Drawdown ft. after hours G.P.M.

USE OF WATER Irrigation Temp. °F. 19

SOURCE OF INFORMATION GR-2390

DRILLER or DIGGER C. A. Shafer, Philomath, Oregon

### ADDITIONAL DATA:

Log  Water Level Measurements  Chemical Analysis  Aquifer Test

### REMARKS:

Clay	13	13
Conglomerate	6	19
Water gravel	4	23
Gravel and clay	26	49
Water bearing gravel	6	55
Blue clay	10	65
Blue gravel-sand streaks of clay-good water	10	75
Sandy clay	14	89