

STATE ENGINEER
Salem, Oregon

LINN
7218

Well Record

STATE WELL NO. 11/3W-8R
COUNTY LINN
APPLICATION NO. GR-2402

OWNER: C. B. Wells

MAILING ADDRESS: Rt. 1, Box 454


LOCATION OF WELL: Owner's No.

CITY AND STATE: Albany, Oregon

SE 1/4 SE 1/4 Sec. 8 T. 11 S, R. 3 W., W.M.

Bearing and distance from section or subdivision

corner N. 28° 50' W. 4.3 chains

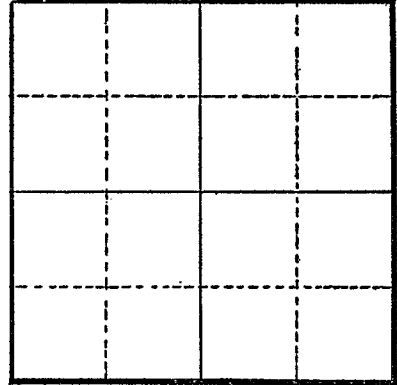

Section

Altitude at well

TYPE OF WELL: Drilled Date Constructed 1952

Depth drilled 63 Depth cased 63

CASING RECORD:

6-inch

FINISH:

Slot perforations from 53 to 63

AQUIFERS:

WATER LEVEL:

14-feet

PUMPING EQUIPMENT: Type Sears 1 1/4" deep well H.P. 2
Capacity 30 G.P.M.

WELL TESTS:

Drawdown ft. after hours G.P.M.
Drawdown ft. after hours G.P.M.

USE OF WATER Irrigation Temp. °F., 19

SOURCE OF INFORMATION GR-2283

DRILLER or DIGGER Morton Sargeant, Philomath, Oregon (Deceased)

ADDITIONAL DATA:

Log Water Level Measurements Chemical Analysis Aquifer Test

REMARKS: