

STATE ENGINEER
Salem, Oregon

LINN
1266

Well Record


STATE WELL NO. 11/3W-9N
COUNTY Linn
APPLICATION NO. GR-3783

OWNER: LeRay & R. S. Hannah MAILING ADDRESS: Route 1, Box 452

LOCATION OF WELL: Owner's No. _____ CITY AND STATE: Albany, Oregon

SW 1/4 SW 1/4 Sec. 9 T. 11 S., R. 3 W., W.M.

Bearing and distance from section or subdivision corner 165' N. & 858' E. of SW Cor. Sec. 9

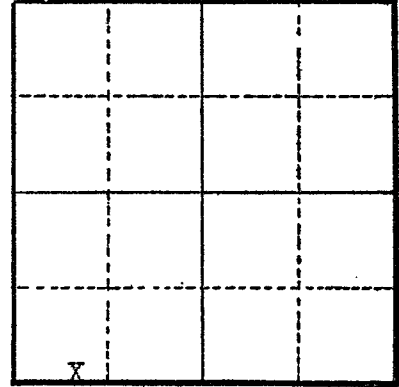

Altitude at well _____

TYPE OF WELL: Drilled Date Constructed 1950

Depth drilled 50 feet Depth cased 50 feet

Section 9

CASING RECORD:

6 inch steel casing set to 50 feet

FINISH:

Slot perforations from 20 to 22 feet and 46 to 50 feet

AQUIFERS:

WATER LEVEL:

PUMPING EQUIPMENT: Type Fairbanks Morse Jet H.P. 3
Capacity _____ G.P.M.

WELL TESTS:

Drawdown _____ ft. after _____ hours _____ G.P.M.
Drawdown _____ ft. after _____ hours _____ G.P.M.

USE OF WATER Irrigation Temp. _____ °F., 19 _____

SOURCE OF INFORMATION Well Registration Statement

DRILLER or DIGGER Mr. Howell

ADDITIONAL DATA:

Log _____ Water Level Measurements _____ Chemical Analysis _____ Aquifer Test _____

REMARKS:

BLVD