

STATE ENGINEER
Salem, Oregon

LINN
7274

Well Record

STATE WELL NO. 11/3W-10A(1)
COUNTY Linn
APPLICATION NO. GR-222

OWNER: John G. Burkhart


MAILING ADDRESS: Rt. 1, Box 242

LOCATION OF WELL: Owner's No. 1

CITY AND STATE: Albany, Oregon

NE 1/4 NE 1/4 Sec. 10 T. 11 N. S., R. 3 E. W., W.M.

Bearing and distance from section or subdivision corner N. 81° 15' E. 23 chs. from SE cor. DLC 39

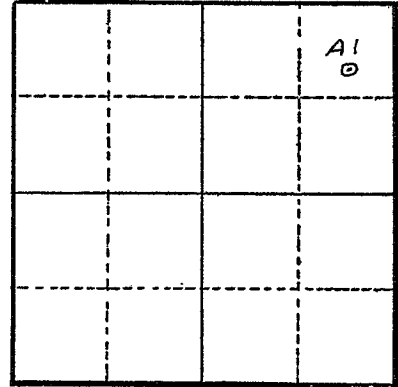

Section 10

Altitude at well 235 ft. Interpolated

TYPE OF WELL: drilled Date Constructed 3/10/48

Depth drilled 165 ft. Depth cased 165 ft.

CASING RECORD: 12 inch casing set from 0 to 165 ft.

FINISH: 2 - 6 inch slit perforations every 10 ft. from 15 to 165 ft.

AQUIFERS: unknown

WATER LEVEL: 8 ft. below land surface

PUMPING EQUIPMENT: Type 4" Fairbanks Morse H.P. 15
Capacity 400 G.P.M.

WELL TESTS:
Drawdown 60 ft. after _____ hours pumping 340 G.P.M.
Drawdown _____ ft. after _____ hours _____ G.P.M.

USE OF WATER irrigation 29 acres Temp. _____ °F., 19

SOURCE OF INFORMATION Reg. St. GR-222

DRILLER or DIGGER Art Clinton; Independence, Oregon

ADDITIONAL DATA:

Log _____ Water Level Measurements _____ Chemical Analysis _____ Aquifer Test _____

REMARKS: