

STATE ENGINEER
Salem, Oregon

LINN 7300
Well Record

STATE WELL NO. 11/3W-12L(1)
COUNTY Linn
APPLICATION NO. GR-38

OWNER: Frank C. Finch

MAILING

ADDRESS: Rt. 1, Box 243A

LOCATION OF WELL: Owner's No. 1


CITY AND

STATE: Albany, Oregon

NE 1/4 SW 1/4 Sec. 12 T. 11 N. S. R. 3 E. W., W.M.

Bearing and distance from section or subdivision

corner N. 21° 51' W. 32.3 chs. from SE cor. SW 1/4 Sec. 12

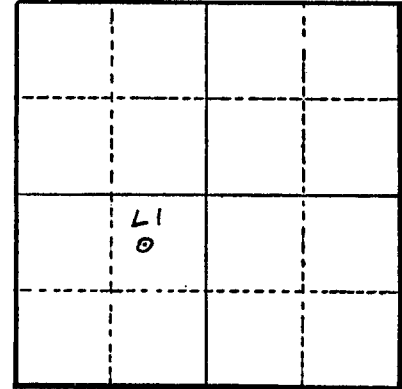

Altitude at well 250 ft. Interpolated

TYPE OF WELL: drilled Date Constructed Jan. 1952

Depth drilled 97 ft. Depth cased 97 ft.

Section 12

CASING RECORD: 6 inch casing set from 0 to 97 ft.

FINISH: Slit perforations used between 77 and 97 ft. 4 perf./foot

AQUIFERS:

WATER LEVEL: Flowing well, not controlled 15 gpm over 3 ft. stand pipe.

PUMPING EQUIPMENT: Type Fairbanks Morse H.P. 5
Capacity 150 G.P.M.

WELL TESTS:

Drawdown 12 ft. after hours 280 G.P.M.

Drawdown ft. after hours G.P.M.

USE OF WATER irrigation 30 acres Temp. °F. 19

SOURCE OF INFORMATION Reg. St. GR-38

DRILLER or DIGGER Wm. M. Slate; Tangent, Oregon

ADDITIONAL DATA:

Log Water Level Measurements Chemical Analysis Aquifer Test

REMARKS: Water rises up around casing when well is capped. Flows 15 gpm over 3 ft. stand pipe.