

STATE ENGINEER
Salem, Oregon

LINN
7336

Well Record

GR- 1778

STATE WELL NO. 11/3W-16M
COUNTY Linn
APPLICATION NO. GR- 1833

OWNER: Ray & Barbara Cleland

MAILING

ADDRESS: Rt. 1, Box 435

LOCATION OF WELL: Owner's No. #2


CITY AND

STATE: Albany, Oregon

NW 1/4 SW 1/4 Sec. 16 T. 11 N. S. R. 3 W., W.M.

Bearing and distance from section or subdivision

corner 3082' S. & 462' E. from NW cor. Sec. 16

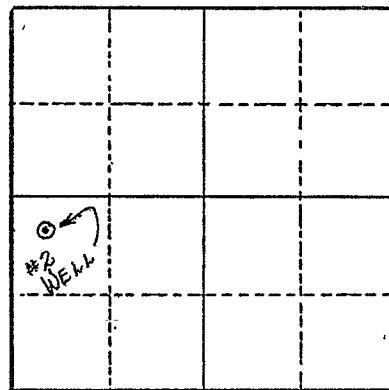

Section 16

Altitude at well 230'

TYPE OF WELL: Drilled Date Constructed 1950

Depth drilled 125' Depth cased 90'

CASING RECORD:

6"

FINISH:

Slot perforations from 0 to 90 ft.

AQUIFERS:

WATER LEVEL:

14'

PUMPING EQUIPMENT: Type Berkeley deep well H.P. 1 1/2
Capacity 30 G.P.M.

WELL TESTS:

Drawdown ft. after hours G.P.M.

Drawdown ft. after hours G.P.M.

USE OF WATER Irrigation Temp. °F. 19

SOURCE OF INFORMATION GR Record

DRILLER or DIGGER Bill Hamilton

ADDITIONAL DATA:

Log N.A. Water Level Measurements Chemical Analysis Aquifer Test

REMARKS:

Irrigation of 3.5 acres.