

STATE ENGINEER
Salem, Oregon

LINN
7350

Well Record

STATE WELL NO. 11/3W-16K
COUNTY Linn
APPLICATION NO. GR-1775

GR- 1719

OWNER: Walter Nelson


MAILING ADDRESS: Rt. 1, Box 399

LOCATION OF WELL: Owner's No. #1

CITY AND STATE: Albany, Oregon

NW 1/4 SE 1/4 Sec. 16 T. 11 S, R. 3 W., W.M.

Bearing and distance from section or subdivision corner 1485' N. & 1749' W. from SE cor. Sec. 16

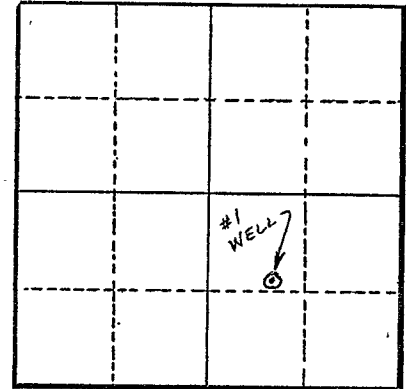

Section 16

Altitude at well 230'

TYPE OF WELL: Drilled Date Constructed 1946

Depth drilled 100' Depth cased 95'

~~SCREENING~~ FINISH:

Slot perforations from 30 to 95 ft.

~~SCREENING~~ CASING RECORD:

10"

AQUIFERS:

WATER LEVEL:

18'

PUMPING EQUIPMENT: Type F. M. turbine H.P. 5
Capacity 150 G.P.M.

WELL TESTS:

Drawdown ft. after hours G.P.M.
Drawdown ft. after hours G.P.M.

USE OF WATER Irrigation Temp. °F. 19

SOURCE OF INFORMATION GR Record

DRILLER or DIGGER Art Sloper

ADDITIONAL DATA:

Log N.A. Water Level Measurements Chemical Analysis Aquifer Test

REMARKS:

Irrigation of 30 acres.