

STATE ENGINEER
Salem, Oregon

LINN
7372

Well Record

GR- 1616

STATE WELL NO. 11/3W-17A
COUNTY Linn
APPLICATION NO. GR- 1665

OWNER: Richard & Erma Cushing


MAILING ADDRESS: Rt. 1, Box 455

LOCATION OF WELL: Owner's No.

CITY AND STATE: Albany, Oregon

NE 1/4 NE 1/4 Sec. 17 T. 11 S., R. 3 W., W.M.

Bearing and distance from section or subdivision corner 11.5 ch. N.24°15'W. from SE cor. DLC #50

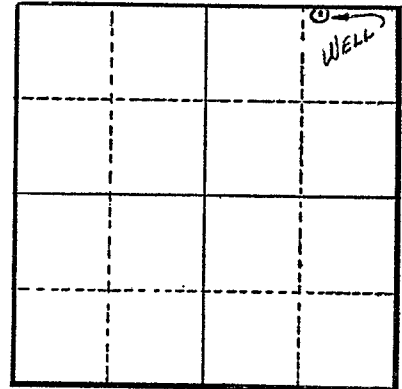

Section 17

Altitude at well 225'

TYPE OF WELL: Drilled Date Constructed 1951

Depth drilled 84' Depth cased 84'

CASING RECORD:

6"

FINISH:

Slot perforations from 64 to 84 ft.

AQUIFERS:

WATER LEVEL:

16'

PUMPING EQUIPMENT: Type F. M. Deep Well Turbine H.P. 5
Capacity 80 G.P.M.

WELL TESTS:

Drawdown 60 ft. after 120 hours G.P.M.

Drawdown ft. after hours G.P.M.

USE OF WATER Irrigation Temp. °F. 19

SOURCE OF INFORMATION GR Record

DRILLER or DIGGER Cy Burkhart


ADDITIONAL DATA:

Log N.A. Water Level Measurements Chemical Analysis Aquifer Test

REMARKS:

Irrigation of 13.4 acres.

²
Now the well is located
173 feet South of the true
place of beginning, & 10' W
of said line.

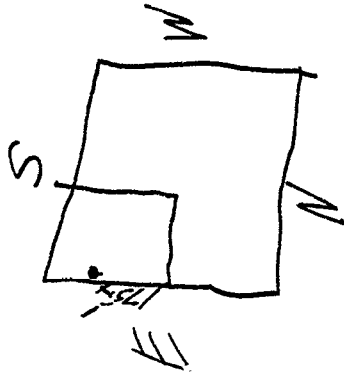

I hope this is sufficient.

Yours truly
Wilbur Fennel

Dear Sir:

As per your request
for a legal description of
your land & the location
of our well:

The land description:

Beginning at a RP spike at the
S¹ corner of Anderson Cox DLC
49 in T 11 S. R 3 W of W.M. in
Linn County, Oregon, and running
N 89° 21' E 464.95 feet to a 1 pipe,
thence S 10° 04' W 235 feet to a
1/2" rod and the true place of
beginning, thence S 10° 04' W
257.90 feet to a 3/4" bolt, thence
N 65° 45' W 120 feet to a 1/2" rod,
thence N 10° 04' E 255.96 feet
to a 1/2" rod, thence S 79° 13' E
116.34 feet to a point of beginning.