

STATE ENGINEER  
Salem, Oregon


LINN  
7374

# Well Record

STATE WELL NO. 11/3W-17G  
COUNTY Linn  
APPLICATION NO. GR-3808

OWNER: Bonita E. Nelson MAILING ADDRESS: Route 1, Box 470  
LOCATION OF WELL: Owner's No. \_\_\_\_\_ CITY AND STATE: Albany, Oregon

SW  $\frac{1}{4}$  NE  $\frac{1}{4}$  Sec. 17 T. 11 <sup>M.</sup> S., R. 3 <sup>E.</sup> W., W.M.  
Bearing and distance from section or subdivision corner 420' N. & 2080' W. of NE Cor. of SE  $\frac{1}{4}$  of Sec. 17

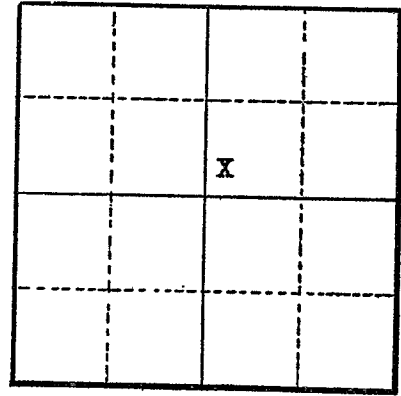

Section 17

Altitude at well \_\_\_\_\_

TYPE OF WELL: Drilled Date Constructed 4/26/53

Depth drilled 50 feet Depth cased 50 feet

CASING RECORD:

8 inch steel casing set to 50 feet

FINISH:

Slot perforation 1 foot apart from 20 to 48 feet

AQUIFERS:

WATER LEVEL:

PUMPING EQUIPMENT: Type 1 1/2" centrifugal H.P. 3  
Capacity \_\_\_\_\_ G.P.M.

WELL TESTS:

Drawdown \_\_\_\_\_ ft. after \_\_\_\_\_ hours \_\_\_\_\_ G.P.M.  
Drawdown \_\_\_\_\_ ft. after \_\_\_\_\_ hours \_\_\_\_\_ G.P.M.

USE OF WATER Irrigation Temp. \_\_\_\_\_ °F. \_\_\_\_\_, 19\_\_\_\_\_

SOURCE OF INFORMATION Well Registration Statement

DRILLER or DIGGER T. J. Burkhart

ADDITIONAL DATA:

Log \_\_\_\_\_ Water Level Measurements \_\_\_\_\_ Chemical Analysis \_\_\_\_\_ Aquifer Test \_\_\_\_\_

REMARKS: