

STATE ENGINEER
Salem, Oregon

LINN
7380

Well Record

STATE WELL NO. 11/3W - 17J
COUNTY LINN
APPLICATION NO. GR-2205

OWNER: Irvin Morton

MAILING ADDRESS: Rt. 1, Box 438


LOCATION OF WELL: Owner's No. _____

CITY AND STATE: Albany, Oregon

NE 1/4 SE 1/4 Sec. 17 T. 11 ^{N.} S., R. 3 ^{W.} W.M.

Bearing and distance from section or subdivision

corner 2145' N. and 264' W.

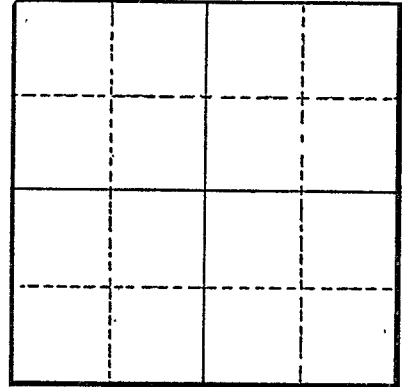

Section _____

Altitude at well _____

TYPE OF WELL: Drilled Date Constructed 1953

Depth drilled 92 Depth cased 27

CASING RECORD:

6-Inch

FINISH:

AQUIFERS:

WATER LEVEL:

15-Feet

PUMPING EQUIPMENT: Type Allis Chalmers Centrifugal H.P. 3
Capacity 60 G.P.M.

WELL TESTS:

Drawdown _____ ft. after _____ hours _____ G.P.M.

Drawdown _____ ft. after _____ hours _____ G.P.M.

USE OF WATER Irrigation Temp. _____ °F. _____, 19_____

SOURCE OF INFORMATION GR-2110

DRILLER or DIGGER Nicholas Klaus, Rt. 4 Albany, Oregon

ADDITIONAL DATA:

Log _____ Water Level Measurements _____ Chemical Analysis _____ Aquifer Test _____

REMARKS: