

STATE ENGINEER
Salem, Oregon

LINN
7412

Well Record

STATE WELL NO. 11/3W-20K(1)
COUNTY Linn
APPLICATION NO. GR-48

OWNER: Oliver & Sarah Schmucker


MAILING ADDRESS: Rt. 1, Box 348 D

LOCATION OF WELL: Owner's No. _____

CITY AND STATE: Albany, Oregon

NW $\frac{1}{4}$ SE $\frac{1}{4}$ Sec. 20 T. 11 S., R. 3 W., W.M.

Bearing and distance from section or subdivision
corner N. 25° E. 34.25 chs. from SW cor. SE $\frac{1}{4}$ Sec. 20

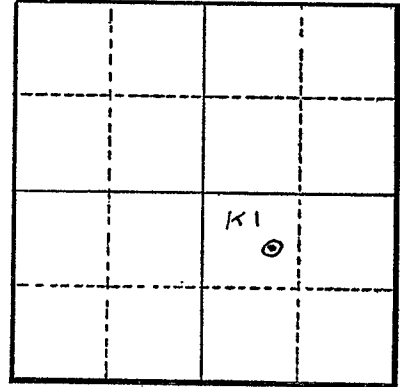

Altitude at well _____

TYPE OF WELL: drilled Date Constructed Apr. 1949

Depth drilled 113 ft. Depth cased 113 ft.

Section 20

CASING RECORD: 8 inch casing set from 0 to 113 ft.

FINISH: Slit perforations from 50 to 113 ft. (one perf. every 4 ft.)

AQUIFERS: _____

WATER LEVEL: 25 ft. below land surface April 1949

PUMPING EQUIPMENT: Type Pacific centrifugal 2 $\frac{1}{2}$ " H.P. 7 $\frac{1}{2}$
Capacity 180 G.P.M.

WELL TESTS:
Drawdown 28 ft. after _____ hours 183 G.P.M.
Drawdown _____ ft. after _____ hours _____ G.P.M.

USE OF WATER irrigation 20 acres Temp. _____ °F. _____, 19____

SOURCE OF INFORMATION Reg. St. GR-48

DRILLER or DIGGER T. J. Burkhart; 169 N 1st W., Tremonton, Utah

ADDITIONAL DATA:

Log _____ Water Level Measurements _____ Chemical Analysis _____ Aquifer Test _____

REMARKS: _____