

STATE ENGINEER  
Salem, Oregon

LINN  
7421

# Well Record

STATE WELL NO. 11/3W-210  
COUNTY LINN  
~~APPLICATION NO.~~ GR-2300

OWNER: Earl and I. H. Lansing


MAILING ADDRESS: Rt. 1, Box 397

LOCATION OF WELL: Owner's No. \_\_\_\_\_

CITY AND STATE: Albany, Oregon

SW 1/4 SE 1/4 Sec. 21 T. 11 N. S., R. 3 W., W.M.

Bearing and distance from section or subdivision corner 528' N. and 2376' West

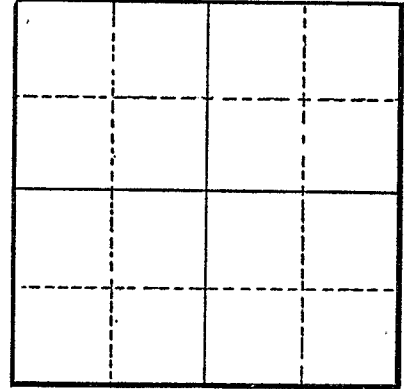

Section .....

Altitude at well .....

TYPE OF WELL: drilled Date Constructed 1945

Depth drilled 114 Depth cased 114

CASING RECORD:

6-inch

FINISH:

AQUIFERS:

WATER LEVEL:

21-feet

PUMPING EQUIPMENT: Type Berkeley Jet H.P. 2  
Capacity 25 G.P.M.

WELL TESTS:

Drawdown ..... ft. after ..... hours ..... G.P.M.  
Drawdown ..... ft. after ..... hours ..... G.P.M.

USE OF WATER Irrigation Temp. ..... °F. ...., 19.....

SOURCE OF INFORMATION GR-2195

DRILLER or DIGGER Russell Reep, Albany, Oregon

ADDITIONAL DATA:

Log ..... Water Level Measurements ..... Chemical Analysis ..... Aquifer Test .....

REMARKS: