

STATE ENGINEER
Salem, Oregon

LINN
7456

Well Record

STATE WELL NO. 11/3W-25D
COUNTY Linn
APPLICATION NO. GR-3806

OWNER: Dan Stutzman

MAILING

ADDRESS: Route 1, Box 352

LOCATION OF WELL: Owner's No.


CITY AND

STATE: Albany, Oregon

NW 1/4 NW 1/4 Sec. 25 T. 11 S., R. 3 W., W.M.

Bearing and distance from section or subdivision

corner 594' S. & 1056' E. of NW Cor. Sec. 25

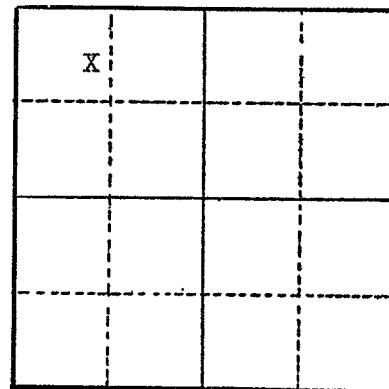

Section 25

Altitude at well

TYPE OF WELL: Drilled Date Constructed 1951

Depth drilled 114 feet Depth cased 114 feet

CASING RECORD:

8 inch steel casing set to 114 feet

FINISH:

AQUIFERS:

WATER LEVEL:

18 feet below surface

PUMPING EQUIPMENT: Type Allis Chalmers centrifugal H.P. 10
Capacity 150 G.P.M.

WELL TESTS:

Drawdown ft. after hours G.P.M.

Drawdown ft. after hours G.P.M.

USE OF WATER Irrigation Temp. °F. 19

SOURCE OF INFORMATION Well Registration Statement

DRILLER or DIGGER Cy Burkhardt

ADDITIONAL DATA:

Log Water Level Measurements Chemical Analysis Aquifer Test

REMARKS: