

STATE ENGINEER
Salem, Oregon

LINN
7457
Well Record

STATE WELL NO. *11/3W-25M*
COUNTY *LINN*
APPLICATION NO. *GR-2982*

OWNER: *George F. Siver*


MAILING ADDRESS: *330 Jefferson St.,*

LOCATION OF WELL: Owner's No. _____

CITY AND STATE: *Albany, Oregon*

NW $\frac{1}{4}$ *SW* $\frac{1}{4}$ Sec. *25* T. *11* *N.* S., R. *3* *E.* W., W.M.

Bearing and distance from section or subdivision
corner *2036' N. and 462' E.*

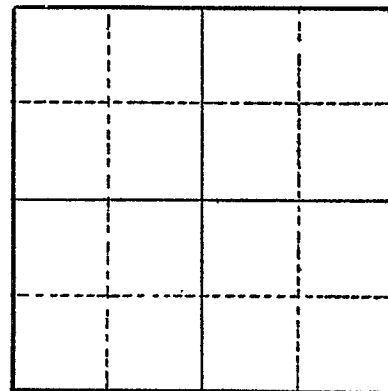

Altitude at well _____

TYPE OF WELL: *drilled* Date Constructed *1950*

Depth drilled *87* Depth cased *87*

Section _____

CASING RECORD:

8-inch

FINISH:

Slot perforations from 67 to 87

AQUIFERS:

WATER LEVEL:

19-feet

PUMPING EQUIPMENT: Type *Fairbanks Morse Jet* H.P. *5*
Capacity *90* G.P.M.

WELL TESTS:

Drawdown *75* ft. after _____ hours *Pumping 105* G.P.M.

Drawdown _____ ft. after _____ hours _____ G.P.M.

USE OF WATER *Irrigation* Temp. _____ °F., 19 _____

SOURCE OF INFORMATION *GR-2793*

DRILLER or DIGGER *Cy Burkhart, Utah*

ADDITIONAL DATA:

Log _____ Water Level Measurements _____ Chemical Analysis _____ Aquifer Test _____

REMARKS: