

STATE ENGINEER
Salem, Oregon

LINN
1478
(LEONARD)

OBSERVATION WELL
Well Record


STATE WELL NO. 11/3W-26A(1)
COUNTY Linn
APPLICATION NO. GR-94

OWNER: Philip & Amelia Roth
MAILING ADDRESS: Rt. 1, Box 359

LOCATION OF WELL: Owner's No. 2
CITY AND STATE: Albany, Oregon

NE 1/4 NE 1/4 Sec. 26 T. 11 N. S. R. 3 E. W., W.M.

Bearing and distance from section or subdivision
corner S. 48° W. 13.5 chs. from NE cor. Sec. 26

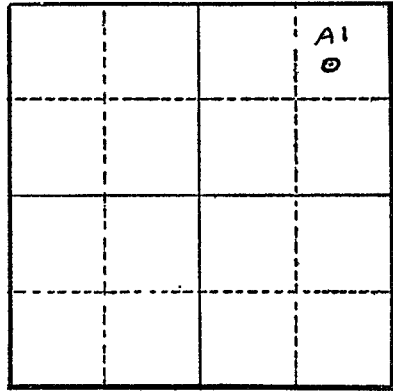

Section 26

Altitude at well 272 ft.

TYPE OF WELL: drilled Date Constructed 10/23/52

Depth drilled 151 ft. Depth cased 151 ft.

CASING RECORD: 8 inch plain end welded casing set from 0 to 151 ft.

FINISH: Torch cut perforations from 132 to 151 ft.
Mills knife perforations from 112 to 120 ft.
Mills knife perforations from 74 to 90 ft.

AQUIFERS: Gravel and sand from ground to 151 ft. varied

WATER LEVEL: 14 ft. below land surface Nov. 6, 1952

PUMPING EQUIPMENT: Type Berkeley turbine H.P. 10
Capacity 150 G.P.M.

WELL TESTS:
Drawdown 120 ft. after hours 225 G.P.M.
Drawdown 70 ft. after hours 120 G.P.M.

USE OF WATER irrigation 29 acres Temp. °F. 19

SOURCE OF INFORMATION Reg. St. GR-

DRILLER or DIGGER

ADDITIONAL DATA:
Log Water Level Measurements Chemical Analysis Aquifer Test

REMARKS:

