

STATE ENGINEER
Salem, Oregon

LINN
7523

Well Record

STATE WELL NO. 11/3W-29J
COUNTY LINN
APPLICATION NO. GR-2345

OWNER: W. A. Graupmann


MAILING ADDRESS: Rt. 3, Box 1056

LOCATION OF WELL: Owner's No. _____

CITY AND STATE: Albany, Oregon

NE 1/4 SE 1/4 Sec. 29 T. 11 N. S., R. 3 E. W., W.M.

Bearing and distance from section or subdivision corner 1797' N. and 1136' W.

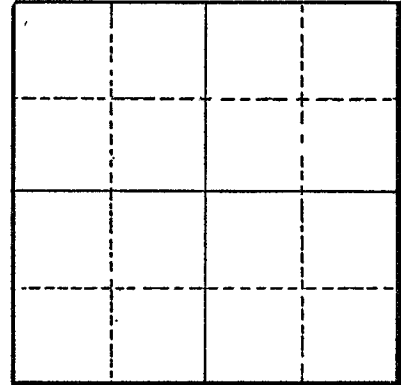

Section _____

Altitude at well _____

TYPE OF WELL: Drilled Date Constructed 1945

Depth drilled 72 Depth cased 72

CASING RECORD:

8-inch

FINISH:

Slot perforations 3/8" to 1/2" x 8" 8 rows from 65' to 72'

AQUIFERS:

Soil, clay and sand

WATER LEVEL:

12-feet

PUMPING EQUIPMENT: Type Peerless Turbine H.P. 5
Capacity 100 G.P.M.

WELL TESTS:

Drawdown 32 ft. after _____ hours Pumping 125 G.P.M.
Drawdown _____ ft. after _____ hours _____ G.P.M.

USE OF WATER Irrigation Temp. _____ °F., 19 _____

SOURCE OF INFORMATION GR-2228

DRILLER or DIGGER _____

ADDITIONAL DATA:

Log X Water Level Measurements _____ Chemical Analysis _____ Aquifer Test _____

REMARKS:

Heavy soil and brown clay 26' 26'
Gravel (small) and yellow clay 17' 43'
Gravel and sand brown some water 8' 51'
Gravel and yellow clay 11' 62'
Black sand 10' 72'