

STATE ENGINEER
Salem, Oregon

LINN
7540

Well Record

STATE WELL NO. 11/3W-31E(1)
COUNTY Linn
APPLICATION NO. GR-605

OWNER: S. O. Griffith


MAILING ADDRESS: Rt. 1

LOCATION OF WELL: Owner's No.

CITY AND STATE: Tangent, Oregon

SW 1/4 NW 1/4 Sec. 31 T. 11 N. S., R. 3 W., W.M.

Bearing and distance from section or subdivision corner N. 73° 45' E. 2.75 chs. from SW cor. NW 1/4 Sec. 31

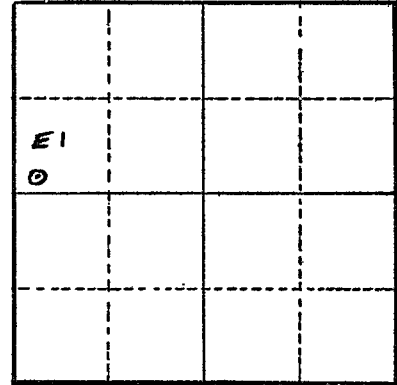

Altitude at well 235 ft. Interpolated

TYPE OF WELL: drilled Date Constructed Apr. 1951

Depth drilled 65 ft. Depth cased 65 ft.

Section 31

CASING RECORD: 6 inch

FINISH:

AQUIFERS:

WATER LEVEL: 15 ft.

PUMPING EQUIPMENT: Type Jacuzzi turbine H.P. 5
Capacity 100 G.P.M.

WELL TESTS:
Drawdown 30 ft. after hours 96 G.P.M.
Drawdown ft. after hours G.P.M.

USE OF WATER irrigation 28.5 ac. Temp. °F., 19

SOURCE OF INFORMATION GR-605

DRILLER or DIGGER

ADDITIONAL DATA:

Log X Water Level Measurements Chemical Analysis Aquifer Test

REMARKS:

