

STATE ENGINEER  
Salem, Oregon

LINN  
7542

# Well Record

STATE WELL NO. 11/3W-31L(1)  
COUNTY Linn  
APPLICATION NO. GR-37

OWNER: J. L. McFarland


MAILING ADDRESS: Rt. 1

LOCATION OF WELL: Owner's No. 1

CITY AND STATE: Tangent, Oregon

NE 1/4 SW 1/4 Sec. 31 T. 11 S., R. 3 W., W.M.

Bearing and distance from section or subdivision  
corner S. 83° E. 14.5 chs. from NE cor. Adam  
Settlemier DLC 65

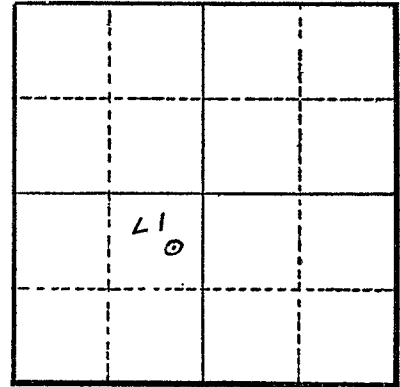

Section 31

Altitude at well 235 ft. Interpolated

TYPE OF WELL: drilled Date Constructed July 1936

Depth drilled 42 ft., Depth cased 42 ft.

CASING RECORD: 8 inch casing set from 0 to 42 ft.

FINISH: Slit perforations - one per foot - from 30 to 42 ft.

AQUIFERS:

WATER LEVEL: 14 ft. below land surface Sept. 1954

PUMPING EQUIPMENT: Type Gould 1 1/2" centrifugal H.P. 5  
Capacity 120 G.P.M.

WELL TESTS:  
Drawdown 28 ft. after \_\_\_\_\_ hours 150 G.P.M.  
Drawdown \_\_\_\_\_ ft. after \_\_\_\_\_ hours \_\_\_\_\_ G.P.M.

USE OF WATER irrigation 52.7 acres Temp. \_\_\_\_\_ °F., 19

SOURCE OF INFORMATION Reg. St. GR-37

DRILLER or DIGGER William M. Slate; Tangent, Oregon

ADDITIONAL DATA:

Log \_\_\_\_\_ Water Level Measurements \_\_\_\_\_ Chemical Analysis \_\_\_\_\_ Aquifer Test \_\_\_\_\_

REMARKS: