

STATE ENGINEER
Salem, Oregon

LINN
7543

Well Record


STATE WELL NO. 11/3W-31M(1)
COUNTY Linn
APPLICATION NO. GR-380

OWNER: George Van de Pol MAILING ADDRESS: Rt. 4, Box 313

LOCATION OF WELL: Owner's No. 1 CITY AND STATE: Corvallis, Oregon

NW 1/4 SW 1/4 Sec. 31 T. 11 N. S. R. 3 E. W., W.M.

Bearing and distance from section or subdivision corner S. 50° 50' E. 35.5 chs. from NW cor.
Charles Molkey DLC 69

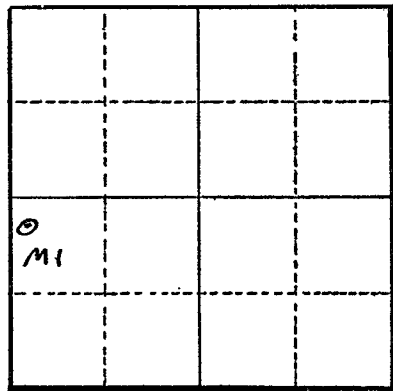

Altitude at well 215 ft.

TYPE OF WELL: drilled Date Constructed 10/12/49

Depth drilled 32 ft. Depth cased 32 ft.

Section 31

CASING RECORD: 10 inch

FINISH:

AQUIFERS:

WATER LEVEL: 18 ft.

PUMPING EQUIPMENT: Type Gould 3" centrifugal H.P. 20
Capacity 450 G.P.M.

WELL TESTS:
Drawdown _____ ft. after _____ hours _____ G.P.M.
Drawdown _____ ft. after _____ hours _____ G.P.M.

USE OF WATER irrigation 44 acres Temp. _____ °F. _____ 19.

SOURCE OF INFORMATION GR-380
DRILLER or DIGGER Shafer & Gellatney; Philomath, Oregon

ADDITIONAL DATA:
Log _____ Water Level Measurements _____ Chemical Analysis _____ Aquifer Test _____

REMARKS: