

STATE ENGINEER  
Salem, Oregon

LINN  
7551

# Well Record


STATE WELL NO. 11/3W-32B  
COUNTY LINN  
APPLICATION NO. GR-2615

OWNER: Harry L. Kropf MAILING ADDRESS: Rt. 3, Box 1062

LOCATION OF WELL: Owner's No. \_\_\_\_\_ CITY AND STATE: Albany, Oregon

NW 1/4 NE 1/4 Sec. 32 T. 11 S., R. 3 W., W.M.

Bearing and distance from section or subdivision corner 578' S. and 280' E.

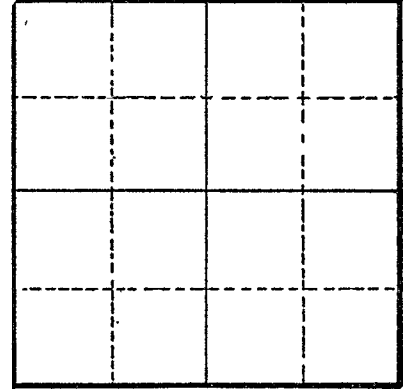

Section \_\_\_\_\_

Altitude at well \_\_\_\_\_

TYPE OF WELL: Drilled Date Constructed 1950

Depth drilled 70 Depth cased 70

### CASING RECORD:

6-inch

### FINISH:

Slot perforations from 60 to 70

### AQUIFERS:

### WATER LEVEL:

PUMPING EQUIPMENT: Type Fairbanks Morse Turbine H.P. 5  
Capacity 100 G.P.M.

### WELL TESTS:

Drawdown \_\_\_\_\_ ft. after \_\_\_\_\_ hours \_\_\_\_\_ G.P.M.  
Drawdown \_\_\_\_\_ ft. after \_\_\_\_\_ hours \_\_\_\_\_ G.P.M.

USE OF WATER Irrigation Temp. \_\_\_\_\_ °F. \_\_\_\_\_, 19\_\_\_\_

SOURCE OF INFORMATION GR-2482

DRILLER or DIGGER Nicholas Klaus, Rt. 4, Albany, Oregon

### ADDITIONAL DATA:

Log \_\_\_\_\_ Water Level Measurements \_\_\_\_\_ Chemical Analysis \_\_\_\_\_ Aquifer Test \_\_\_\_\_

### REMARKS: