

STATE ENGINEER
Salem, Oregon

LINN
7552

Well Record

STATE WELL NO. 11/3W - 32C
COUNTY LINN
APPLICATION NO. GR-2208

OWNER: Hugo W. and Olive H. Ehrlich


MAILING ADDRESS: Rt. 3, Box 1058

LOCATION OF WELL: Owner's No. _____

CITY AND STATE: Albany, Oregon

NE $\frac{1}{4}$ NW $\frac{1}{4}$ Sec. 32 T. 11 N. S., R. 3 E. W., W.M.

Bearing and distance from section or subdivision corner S. 33° 30' W. 9.5 chains

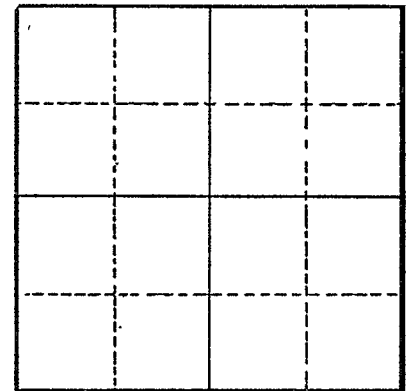

Section _____

Altitude at well _____

TYPE OF WELL: Drilled Date Constructed 1952

Depth drilled 102 Depth cased 102

CASING RECORD:

10-Inch

FINISH:

- Perforations from 27 to 29
- Perforations from 35 to 39
- Perforations from 55 to 59
- Perforations from 99 to 102

AQUIFERS:

Clay and gravel

WATER LEVEL:

35-Feet

PUMPING EQUIPMENT: Type Berkeley Turbine

H.P. 10

Capacity 175 G.P.M.

WELL TESTS:

Drawdown 57 ft. after _____ hours Pumping 300 G.P.M.

Drawdown _____ ft. after _____ hours _____ G.P.M.

USE OF WATER Irrigation Temp. _____ °F., 19 _____

SOURCE OF INFORMATION GR-2113

DRILLER or DIGGER Raymond Gellatly, Philomath, Oregon

ADDITIONAL DATA:

Log Water Level Measurements _____ Chemical Analysis _____ Aquifer Test _____

REMARKS:

