

STATE ENGINEER
Salem, Oregon

LINN
7555

Well Record

STATE WELL NO. 11/3W-33B
COUNTY Linn
APPLICATION NO. GR-1282


GR- 1239

OWNER: Ed Roth
MAILING ADDRESS: Rt. 1

LOCATION OF WELL: Owner's No. _____
CITY AND STATE: Albany, Oregon

NW 1/4 NE 1/4 Sec. 33 T. 11 S., R. 3 W., W.M.

Bearing and distance from section or subdivision
corner S87°45'E. 14.5 ch. from N 1/4 cor. Sec. 33.

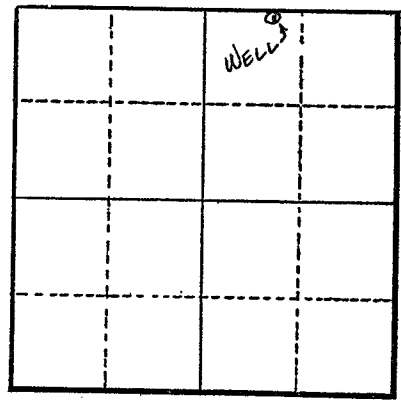

Section 33

Altitude at well 255 ft.

TYPE OF WELL: Drilled Date Constructed 1949

Depth drilled 118 ft. Depth cased 118 ft.

CASING RECORD:
6 inch

FINISH:

Slot perforations from 38 to 42 ft.
" " " " 114 to 118 ft.

AQUIFERS:

WATER LEVEL:

40 ft.

PUMPING EQUIPMENT: Type Deep well H.P. 5
Capacity 100 G.P.M.

WELL TESTS:

Drawdown 30 ft. after 150 hours G.P.M.
Drawdown _____ ft. after _____ hours G.P.M.

USE OF WATER Irrigation Temp. °F. 19

SOURCE OF INFORMATION G.R. Record

DRILLER or DIGGER T. J. Burkhart

ADDITIONAL DATA:
Log N.A. Water Level Measurements Chemical Analysis Aquifer Test

REMARKS:

Irrigation of 5.3 acres.