

STATE ENGINEER
Salem, Oregon

*Linn
7643*

Well Record

STATE WELL NO. 12/2W-2D 2
COUNTY LINN
APPLICATION NO. GR-2870
GR-2704 *W88*


OWNER: William H. and Marie S. Long MAILING ADDRESS: Rt. 2, Box 134

LOCATION OF WELL: Owner's No. #1 CITY AND STATE: Lebanon, Oregon

NW 1/4 NW 1/4 Sec. 2 T. 12 N. S. R. 2 E. W., W.M.

Bearing and distance from section or subdivision corner S. 14° 57.38' W. from SW cor. W.B.

Gore DLC No. 71.

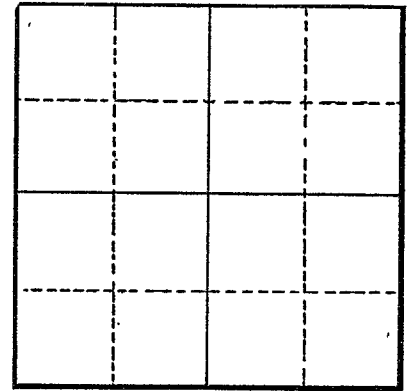

Section _____

Altitude at well _____

TYPE OF WELL: drilled Date Constructed 1942

Depth drilled 69 (77 ^{*LSO*}) Depth cased 50

CASING RECORD:

8-inch

FINISH:

Slot perforations from 10 to 50

AQUIFERS:

WATER LEVEL:

15-feet

PUMPING EQUIPMENT: Type Gould Centrifugal H.P. 20
Capacity 400 G.P.M.

WELL TESTS:

Drawdown 18 ft. after _____ hours Pumping 640 G.P.M.
Drawdown _____ ft. after _____ hours _____ G.P.M.

USE OF WATER irrigation Temp. °F. _____, 19

SOURCE OF INFORMATION GR-2870 2704

DRILLER or DIGGER Marion West, Salem, Oregon

ADDITIONAL DATA:

Log _____ Water Level Measurements _____ Chemical Analysis _____ Aquifer Test _____

REMARKS: