

STATE ENGINEER  
Salem, Oregon

Linn  
7688

# Well Record

STATE WELL NO. 12/2W-3G  
COUNTY Linn  
APPLICATION NO. GR-4222

OWNER: Glenn Huston


MAILING ADDRESS: Box 246

LOCATION OF WELL: Owner's No.

CITY AND STATE: Lebanon, Oregon

SW 1/4 NE 1/4 Sec. 3 T. 12 N. S., R. 2 W., W.M.

Bearing and distance from section or subdivision corner 2640' S. & 1419' W. of NE Cor. Sec. 3

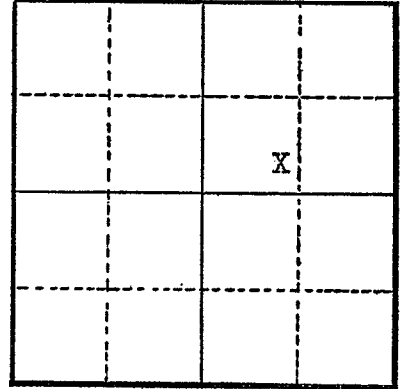

Section 3

Altitude at well

TYPE OF WELL: Drilled Date Constructed 1948

Depth drilled 120 ft. Depth cased 120 ft.

### CASING RECORD:

8 inch steel casing set to 120 feet

### FINISH:

Slot perforations from 20 to 45 feet

### AQUIFERS:

### WATER LEVEL:

PUMPING EQUIPMENT: Type Fairbanks Morse jet H.P. 15  
Capacity 400 G.P.M.

### WELL TESTS:

Drawdown ft. after hours G.P.M.  
Drawdown ft. after hours G.P.M.

USE OF WATER Irrigation Temp. °F. 19

SOURCE OF INFORMATION Well Registration Statement Cert. # GR-3765

DRILLER or DIGGER Slate Drilling Co.

### ADDITIONAL DATA:

Log Water Level Measurements Chemical Analysis Aquifer Test

### REMARKS: