

STATE ENGINEER  
Salem, Oregon

Linn  
7689

# Well Record

STATE WELL NO. 12/2W-3J  
COUNTY LINN  
APPLICATION NO. GR-2612

OWNER: Mrs. Sara J. Morris


MAILING ADDRESS: Rt. 2.

LOCATION OF WELL: Owner's No.

CITY AND STATE: Lebanon, Oregon

NE 1/4 SE 1/4 Sec. 3 T. 12 S., R. 2 W., W.M.

Bearing and distance from section or subdivision corner 297' S.

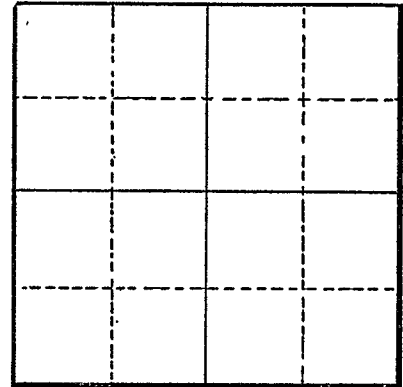

Section

Altitude at well

TYPE OF WELL: Drilled Date Constructed 1953

Depth drilled 28 Depth cased 28

### CASING RECORD:

8-inch

### FINISH:

Slot perforations from 18 to 28

### AQUIFERS:

### WATER LEVEL:

10-feet

PUMPING EQUIPMENT: Type Pacific H.P.

Capacity 300 G.P.M.

### WELL TESTS:

Drawdown ft. after hours G.P.M.

Drawdown ft. after hours G.P.M.

USE OF WATER Irrigation Temp. °F., 19

SOURCE OF INFORMATION GR-2479

DRILLER or DIGGER Bob White, White Oaks Addition, Lebanon, Oregon

### ADDITIONAL DATA:

Log Water Level Measurements Chemical Analysis Aquifer Test

### REMARKS: