

STATE ENGINEER
Salem, Oregon

Linn
7701

Well Record

STATE WELL NO. 12/2W-4P(1)
COUNTY Linn
APPLICATION NO. GR-307

OWNER: Edgar R. Draper


MAILING ADDRESS: Rt. 2

LOCATION OF WELL: Owner's No. 1

CITY AND STATE: Lebanon, Oregon

SE 1/4 SW 1/4 Sec. 4 T. 12 N. S., R. 2 E. W., W.M.

Bearing and distance from section or subdivision
corner S. 2° 30' W. 15 chs. from NW cor. Jacob
Kees DLC 42

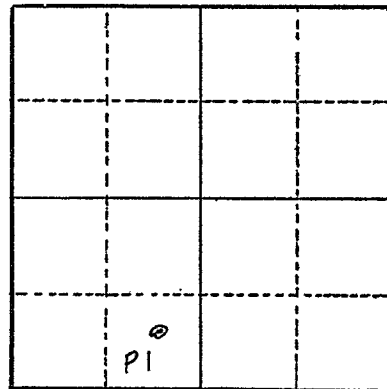

Altitude at well 320 ft. Interpolated

TYPE OF WELL: drilled Date Constructed 5/8/50

Depth drilled 60 ft. Depth cased 60 ft.

Section 4

CASING RECORD: 12 inch casing set from 0 to 60 ft.

FINISH: Slit perforations set from 50 to 60 ft.

AQUIFERS: none

WATER LEVEL: 16 ft. below land surface

PUMPING EQUIPMENT: Type deep well turbine H.P. 7 1/2
Capacity 200 G.P.M.

WELL TESTS:
Drawdown 30 ft. after hours pumping 200 G.P.M.
Drawdown ft. after hours G.P.M.

USE OF WATER irrigation 29.0 acres Temp. °F. 19

SOURCE OF INFORMATION Reg. St. GR-307

DRILLER or DIGGER unknown

ADDITIONAL DATA:

Log Water Level Measurements Chemical Analysis Aquifer Test

REMARKS: