

STATE ENGINEER
Salem, Oregon

Linn 8004
Well Record

STATE WELL NO. 12/2W-15M
COUNTY Linn
APPLICATION NO. GR-3250

OWNER: Joseph A. Anthony

MAILING
ADDRESS:

Brownsville

LOCATION OF WELL: Owner's No. _____


CITY AND
STATE:

Oregon

N.
W.
NW $\frac{1}{4}$ SW $\frac{1}{4}$ Sec. 15 T. 12 S., R. 2 W., W.M.

Bearing and distance from section or subdivision

corner 2475' N. 990' E. of the S.W. corner
of Section 15

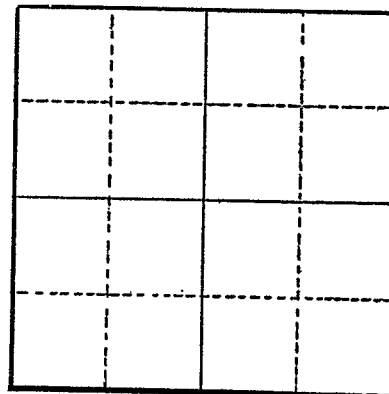

Altitude at well _____

TYPE OF WELL: drilled Date Constructed 1950

Depth drilled 60 Depth cased 54

Section _____

CASING RECORD:

10 inch

FINISH:

Slot perforations from 37 to 39

AQUIFERS:

WATER LEVEL:

PUMPING EQUIPMENT: Type Jacuzzi Centrifugal H.P. 2½
Capacity _____ G.P.M.

WELL TESTS:

Drawdown _____ ft. after _____ hours _____ G.P.M.

Drawdown _____ ft. after _____ hours _____ G.P.M.

USE OF WATER Irrigation Temp. _____ °F. _____, 19____

SOURCE OF INFORMATION GR-3024

DRILLER or DIGGER Geo. McGowan, Airport Road, Lebanon, Oregon

ADDITIONAL DATA:

Log _____ Water Level Measurements _____ Chemical Analysis _____ Aquifer Test _____

REMARKS:

State Engineer Salem Oregon
Now this is the Discriptions of property as
Written on Warranty Deed

RECEIVED
APR 3 1958
STATE ENGINEER
SALEM, OREGON

The West 71 feet of even width of the
South 211.5 feet of even width of lot
17, Block 3, Harmony Subdivision to
Linn Co Oregon

This is the way it lays

