

STATE ENGINEER
Salem, Oregon

Linn
8073

Well Record

STATE WELL NO. 12/2W - 21L
COUNTY LINN
APPLICATION NO. GR-2124

OWNER: JOHN G. LUSCHER


MAILING ADDRESS: Rt. 2, Box 116 E

LOCATION OF WELL: Owner's No. _____

CITY AND STATE: Lebanon, Oregon

NE $\frac{1}{4}$ SW $\frac{1}{4}$ Sec. 21 T. 12 $\frac{N.}{S.}$, R. 2 $\frac{E.}{W.}$, W.M.

Bearing and distance from section or subdivision corner 2200' E. and 1900' N.

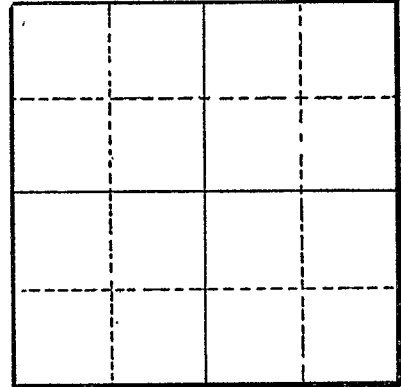

Section _____

Altitude at well _____

TYPE OF WELL: Drilled Date Constructed 1952

Depth drilled 54 Depth cased 50

CASING RECORD:

12-Inch

FINISH:

Perforations from 10 to 50

AQUIFERS:

WATER LEVEL:

21-Feet

PUMPING EQUIPMENT: Type Layn Bowler H.P. 7 $\frac{1}{2}$
Capacity 510 G.P.M.

WELL TESTS:

Drawdown _____ ft. after _____ hours _____ G.P.M.
Drawdown _____ ft. after _____ hours _____ G.P.M.

USE OF WATER Irrigation Temp. _____ °F. _____, 19_____

SOURCE OF INFORMATION GR-2040

DRILLER or DIGGER Art Clinton, Independence, Oregon

ADDITIONAL DATA:

Log _____ Water Level Measurements _____ Chemical Analysis _____ Aquifer Test _____

REMARKS: