

STATE ENGINEER
Salem, Oregon

Linn
8232
Well Record

STATE WELL NO. 12/2W-23B
COUNTY LINN
APPLICATION NO. GR-4209

OWNER: Cascades Plywood Corp


MAILING
ADDRESS: Lebanon

LOCATION OF WELL: Owner's No. _____

CITY AND
STATE: Oregon

NW $\frac{1}{4}$ NE $\frac{1}{4}$ Sec. 23 T. 12 S. R. 2 W., W.M.

Bearing and distance from section or subdivision
corner 2070' W & 405' S of NE cor Sec 23

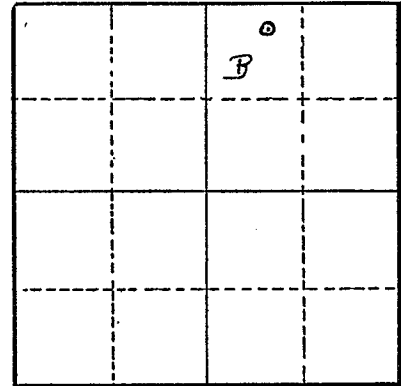

Section 23

Altitude at well _____

TYPE OF WELL: Drilled Date Constructed 1940

Depth drilled 180' Depth cased 180'

CASING RECORD:

10-inch

FINISH:

AQUIFERS:

WATER LEVEL:

NA

PUMPING EQUIPMENT: Type Deming Turbine H.P. 30
Capacity 600 G.P.M.

WELL TESTS:

Drawdown _____ ft. after _____ hours 600 G.P.M.

Drawdown _____ ft. after _____ hours _____ G.P.M.

USE OF WATER mfg & ind Temp. _____ °F. _____, 19____

SOURCE OF INFORMATION GR-3963

DRILLER or DIGGER _____

ADDITIONAL DATA:

Log NA Water Level Measurements _____ Chemical Analysis _____ Aquifer Test _____

REMARKS: