

STATE ENGINEER
Salem, Oregon

LINN
8241

Well Record

STATE WELL NO. 11/4W-1H
COUNTY LINN
APPLICATION NO. GR-2543


OWNER: Chas K. McCormack, Secretary,
Cloverdale Farms, Inc.

MAILING ADDRESS: P. O. Box 392

LOCATION OF WELL: Owner's No. #1

CITY AND STATE: Albany, Oregon

SE 1/4 NE 1/4 Sec. 1 T. 11 S., R. 4 W., W.M.

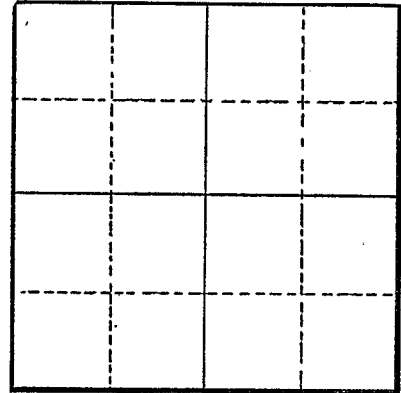

Bearing and distance from section or subdivision corner 2574' S. & 695' W.

Altitude at well

TYPE OF WELL: Drilled Date Constructed 1950

Depth drilled 30 Depth cased 30

Section

CASING RECORD:

6-inch

FINISH:

AQUIFERS:

WATER LEVEL:

18-feet

PUMPING EQUIPMENT: Type Centrifugal H.P. 25
Capacity 300 G.P.M.

WELL TESTS:

Drawdown 1 ft. after hours Pumping 400 G.P.M.

Drawdown ft. after hours G.P.M.

USE OF WATER Irrigation Temp. °F. 19

SOURCE OF INFORMATION GR-2403

DRILLER or DIGGER Bill Hamilton, Albany, Oregon

ADDITIONAL DATA:

Log Water Level Measurements Chemical Analysis Aquifer Test

REMARKS: