

STATE ENGINEER
Salem, Oregon

LINN
8324

Well Record

STATE WELL NO. 11/4W-13C
COUNTY Linn
APPLICATION NO. GR-2232

OWNER: Fred A. Weber


MAILING ADDRESS: 2140 Broadway

LOCATION OF WELL: Owner's No.

CITY AND STATE: Albany, Oregon

NE 1/4 NW 1/4 Sec. 13 T. 11 S., R. 4 W., W.M.

Bearing and distance from section or subdivision corner W 915', N 10 1/2°, 1344' from SE corner of Geo. Cline D. L. C84

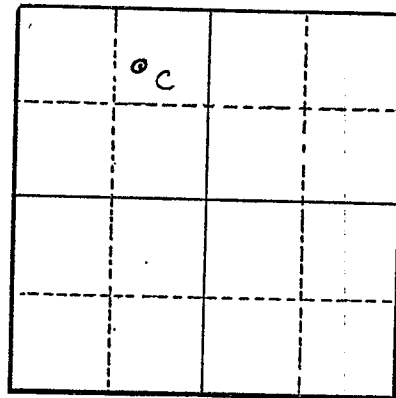

Section 13

Altitude at well

TYPE OF WELL: Drilled Date Constructed 1950

Depth drilled 92' Depth cased 45'

CASING RECORD:

4-inch

FINISH:

AQUIFERS:

WATER LEVEL:

20'

PUMPING EQUIPMENT: Type Pacific Jet

Capacity 15 G.P.M.

H.P. 3/4

WELL TESTS:

Drawdown ft. after hours G.P.M.

Drawdown ft. after hours G.P.M.

USE OF WATER Irrigation Temp. °F., 19

SOURCE OF INFORMATION GR-3839

DRILLER or DIGGER Morten Sargent

ADDITIONAL DATA:

Log NA Water Level Measurements Chemical Analysis Aquifer Test

REMARKS: