

STATE ENGINEER
Salem, Oregon

LINN
8325

Well Record

STATE WELL NO. 11/LW - 13C
COUNTY LINN
APPLICATION NO. GR-2209

OWNER: Pernal and Weyona Dodele

MAILING ADDRESS: 2540 Broadway


LOCATION OF WELL: Owner's No.

CITY AND STATE: Albany, Oregon

NE 1/4 NW 1/4 Sec. 13 T. 11 N. S., R. 4 E. W., W.M.

Bearing and distance from section or subdivision

corner 1254' S. and 1815' E.

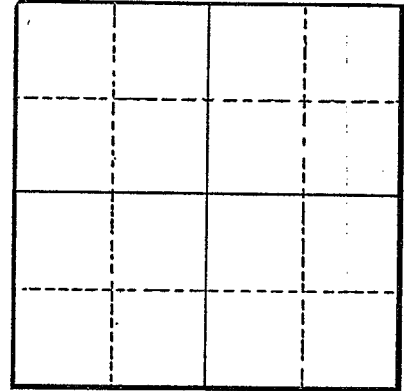

Section

Altitude at well

TYPE OF WELL: Drilled Date Constructed 1945

Depth drilled 49 Depth cased 21

CASING RECORD:

4-Inch

FINISH:

Perforations from 17 to 21

AQUIFERS:

WATER LEVEL:

18-Feet

PUMPING EQUIPMENT: Type Advance Deep well H.P. 1/2
Capacity 600 G.P.M.

WELL TESTS:

Drawdown ft. after hours G.P.M.
Drawdown ft. after hours G.P.M.

USE OF WATER Irrigation Temp. °F. 19

SOURCE OF INFORMATION GR-2114

DRILLER or DIGGER Bill Slate, Tangent, Oregon

ADDITIONAL DATA:

Log Water Level Measurements Chemical Analysis Aquifer Test

REMARKS: