


OWNER: Robert E. and Marian A. Chandler MAILING ADDRESS: 3522 S. Pacific Blvd.

LOCATION OF WELL: Owner's No. CITY AND STATE: Albany, Oregon

SW 1/4 SE 1/4 Sec. 13 T. 11 N. S., R. 4 W., W.M.

Bearing and distance from section or subdivision corner 792' N. and 1584' S. of the S.E. corner of Section 13

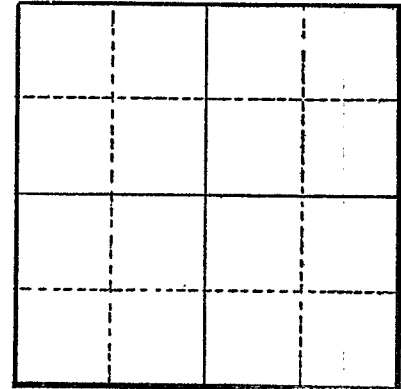

Section

Altitude at well

TYPE OF WELL: drilled Date Constructed 1946

Depth drilled 60 Depth cased 60

CASING RECORD:

6 inch

FINISH:

Slot perforations from 50 to 60

AQUIFERS:

WATER LEVEL:

PUMPING EQUIPMENT: Type Berkeley Centrifugal H.P. 1 1/2
Capacity G.P.M.

WELL TESTS:

Drawdown ft. after hours G.P.M.
Drawdown ft. after hours G.P.M.

USE OF WATER Irrigation Temp. °F. 19

SOURCE OF INFORMATION GR-2994

DRILLER or DIGGER

ADDITIONAL DATA:

Log Water Level Measurements Chemical Analysis Aquifer Test

REMARKS: