

STATE ENGINEER
Salem, Oregon

LINN
8332

Well Record

STATE WELL NO. 11/LW-13J(1)
COUNTY Linn
APPLICATION NO. GR-390

OWNER: Albany Food Products Inc.

MAILING ADDRESS:

LOCATION OF WELL: Owner's No. 1

CITY AND STATE: Albany, Oregon


NE 1/4 SE 1/4 Sec. 13 T. 11 N. S., R. 4 E. W., W.M.

Bearing and distance from section or subdivision corner

Altitude at well 213 ft. Interpolated

TYPE OF WELL: drilled Date Constructed June 1949

Depth drilled 42 ft. Depth cased

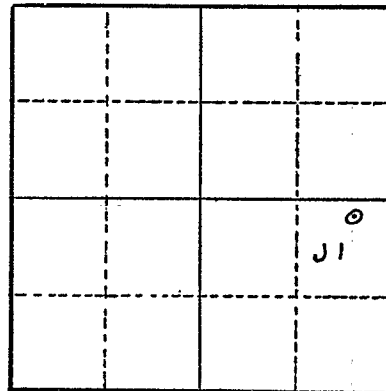

Section 13

CASING RECORD:

FINISH:

AQUIFERS:

WATER LEVEL:

PUMPING EQUIPMENT: Type _____ H.P. _____
Capacity _____ G.P.M.

WELL TESTS:
Drawdown _____ ft. after _____ hours _____ G.P.M.
Drawdown _____ ft. after _____ hours _____ G.P.M.

USE OF WATER _____ Temp. _____ °F. _____, 19____

SOURCE OF INFORMATION _____

DRILLER or DIGGER _____

ADDITIONAL DATA:

Log _____ Water Level Measurements _____ Chemical Analysis _____ Aquifer Test _____

REMARKS: