

STATE ENGINEER  
Salem, Oregon

LINN  
8387

# Well Record

STATE WELL NO. 11/4W - 15G  
COUNTY LINN  
APPLICATION NO. GR-1980

OWNER: W. R. and Beulah Marie Sawtell


MAILING ADDRESS: Route 3, Box 697

LOCATION OF WELL: Owner's No. \_\_\_\_\_

CITY AND STATE: Albany, Oregon

SW,  $\frac{1}{4}$  NE  $\frac{1}{4}$  Sec. 15 T. 11 <sup>N.</sup> S., R. 4 <sup>E.</sup> W., W.M.

Bearing and distance from section or subdivision corner N. 76° E. 26.25 chains

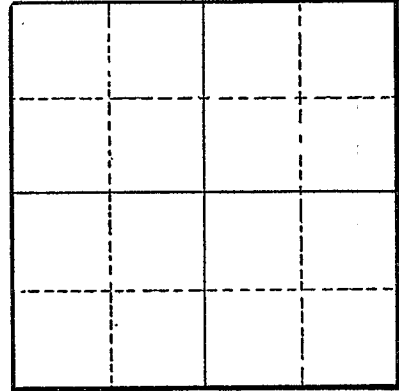

Section \_\_\_\_\_

Altitude at well \_\_\_\_\_

TYPE OF WELL: Drilled Date Constructed 1945

Depth drilled 42' Depth cased 42'

CASING RECORD:

4-inch

FINISH:

Slot Perforations from 30 to 42

AQUIFERS:

Not available

WATER LEVEL:

18-feet

PUMPING EQUIPMENT: Type Deepwell Jet H.P. 3  
Capacity 50 G.P.M.

WELL TESTS:

Drawdown \_\_\_\_\_ ft. after \_\_\_\_\_ hours \_\_\_\_\_ G.P.M.  
Drawdown \_\_\_\_\_ ft. after \_\_\_\_\_ hours \_\_\_\_\_ G.P.M.

USE OF WATER Irrigation Temp. \_\_\_\_\_ °F. \_\_\_\_\_, 19\_\_\_\_

SOURCE OF INFORMATION GR-1902

DRILLER or DIGGER Unknown

ADDITIONAL DATA:

Log \_\_\_\_\_ Water Level Measurements \_\_\_\_\_ Chemical Analysis \_\_\_\_\_ Aquifer Test \_\_\_\_\_

REMARKS:

Log Not available