

STATE ENGINEER
Salem, Oregon

LINN Well Record

8405

STATE WELL NO. 11/4W-21L
COUNTY Linn
APPLICATION NO. GR-1470

GR- 1419

OWNER: Howard Atkeson


MAILING ADDRESS: Rt. 3, Box 750

LOCATION OF WELL: Owner's No. #1

CITY AND STATE: Albany, Oregon

NE 1/4 SW 1/4 Sec. 21 T. 11 S., R. 4 W., W.M.

Bearing and distance from section or subdivision corner S. 76° E. 39.5 ch. from NW cor. of SW 1/4 of Sec. 21.

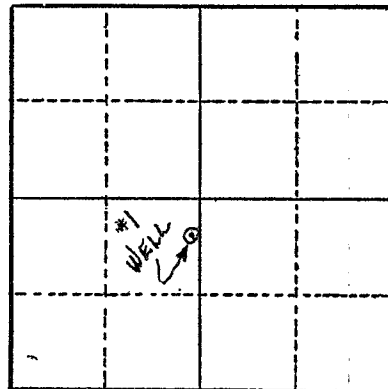

Section 21

Altitude at well 200'

TYPE OF WELL: Drilled Date Constructed 1950

Depth drilled 28' Depth cased 28'

CASING RECORD:
8"

FINISH:

Slot perforations from 20' to 28'

AQUIFERS:

WATER LEVEL:

12'

PUMPING EQUIPMENT: Type Pacific 3" Cent. H.P. 20

Capacity 500 G.P.M.

WELL TESTS:

Drawdown _____ ft. after _____ hours _____ G.P.M.

Drawdown _____ ft. after _____ hours _____ G.P.M.

USE OF WATER Irrigation Temp. _____ °F. _____, 19

SOURCE OF INFORMATION GR Record

DRILLER or DIGGER Claude Schaeffer

ADDITIONAL DATA:

Log N.A. Water Level Measurements _____ Chemical Analysis _____ Aquifer Test _____

REMARKS:

Irrigation of 77.5 acres.