

STATE ENGINEER
Salem, Oregon

LINN Well Record
8406

STATE WELL NO. 11/4W-21N
COUNTY LINN
APPLICATION NO. GR-2861

OWNER: Lyle Truax


MAILING ADDRESS: 104-G Clark Co. Courthouse

LOCATION OF WELL: Owner's No. #4

CITY AND STATE: Vancouver, Washington

SW 1/4 SW 1/4 Sec. 21 T. 11 N. S., R. 4 W. W.M.

Bearing and distance from section or subdivision corner N. 45° E. 7 chains

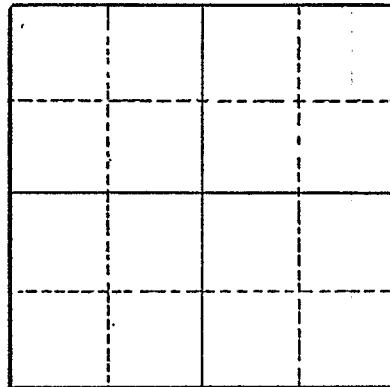

Section

Altitude at well

TYPE OF WELL: drilled Date Constructed 1954

Depth drilled 20 Depth cased 20

CASING RECORD:

12-inch

FINISH:

Slot perforations from 15 to 20

AQUIFERS:

WATER LEVEL:

6-feet

PUMPING EQUIPMENT: Type Gardner Denver 3" centrifugal H.P. 30
Capacity 500 G.P.M.

WELL TESTS:

Drawdown ft. after hours G.P.M.
Drawdown ft. after hours G.P.M.

USE OF WATER Irrigation Temp. °F., 19

SOURCE OF INFORMATION GR-2695

DRILLER or DIGGER Bill Hamilton Drilling Co., 838 E. Third Ave., Albany, Oregon

ADDITIONAL DATA:

Log Water Level Measurements Chemical Analysis Aquifer Test

REMARKS: