

STATE ENGINEER  
Salem, Oregon

# LINN Well Record

8439

STATE WELL NO. 11/LW-22F(1)  
COUNTY Linn  
APPLICATION NO. GR-142

OWNER: Philip W. Haddan


MAILING ADDRESS: Rt. 3, Box 736

LOCATION OF WELL: Owner's No. 2

CITY AND STATE: Albany, Oregon

SE 1/4 NW 1/4 Sec. 22 T. 11 N. S. R. 4 W., W.M.

Bearing and distance from section or subdivision  
corner S. 13° 50' E. 37.5 chs. from NW cor.  
Wm. Moore DLC 60

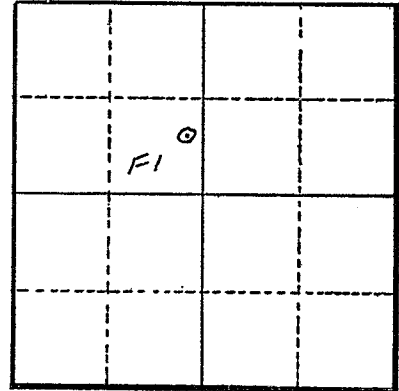

Section 22

Altitude at well 205 ft. Interpolated

TYPE OF WELL: drilled Date Constructed 6/3/48

Depth drilled 31 ft. Depth cased 31 ft.

CASING RECORD: 8 inch casing set from 0 to 31 ft.

FINISH: Slit perforations set from 12 to 31 ft.

AQUIFERS: unknown

WATER LEVEL: 10 ft. below land surface

PUMPING EQUIPMENT: Type 1 1/2" centrifugal H.P. 5  
Capacity 100 G.P.M.

WELL TESTS:  
Drawdown 20 ft. after \_\_\_\_\_ hours pumping 100 G.P.M.  
Drawdown \_\_\_\_\_ ft. after \_\_\_\_\_ hours \_\_\_\_\_ G.P.M.

USE OF WATER irrigation 49 acres Temp. \_\_\_\_\_ °F. 19

SOURCE OF INFORMATION Reg. St. GR-142

DRILLER or DIGGER C. W. Shaffer; Philomath, Oregon

ADDITIONAL DATA:

Log \_\_\_\_\_ Water Level Measurements \_\_\_\_\_ Chemical Analysis \_\_\_\_\_ Aquifer Test \_\_\_\_\_

REMARKS: