

STATE ENGINEER
Salem, Oregon

LINN 8440
Well Record


STATE WELL NO. 11/4w-22M
COUNTY LINN
APPLICATION NO. GR-2850

OWNER: Harveys and Erma E. Commons MAILING ADDRESS: Rt. 3, Box 742

LOCATION OF WELL: Owner's No. CITY AND STATE: Albany, Oregon

NW 1/4 SW 1/4 Sec. 22 T. 11 S. R. 4 W., W.M.

Bearing and distance from section or subdivision corner N. 17° 1340' E.

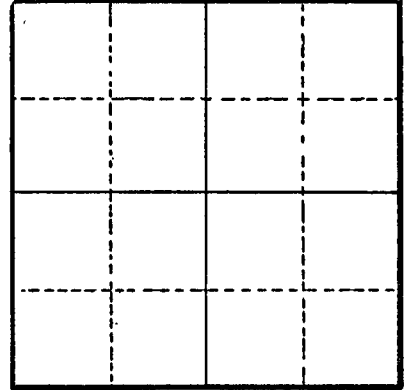

Section

Altitude at well

TYPE OF WELL: drilled Date Constructed 1948

Depth drilled 48 Depth cased 48

CASING RECORD:

5-inch

FINISH:

Slot perforations from 38 to 48

AQUIFERS:

WATER LEVEL:

26-feet

PUMPING EQUIPMENT: Type Montgomery Ward Jet H.P. 2
Capacity 30 G.P.M.

WELL TESTS:

Drawdown ft. after hours G.P.M.

Drawdown ft. after hours G.P.M.

USE OF WATER irrigation Temp. °F., 19

SOURCE OF INFORMATION GR-2684

DRILLER or DIGGER Schaeffer, Philomath, Oregon

ADDITIONAL DATA:

Log Water Level Measurements Chemical Analysis Aquifer Test

REMARKS: