

STATE ENGINEER
Salem, Oregon

LINN
8548

Well Record


STATE WELL NO. 11/LW-25K(1)
COUNTY Linn
APPLICATION NO. GR-309

OWNER: Loren A. & Mildred Campbell MAILING ADDRESS: _____

LOCATION OF WELL: Owner's No. 1 CITY AND STATE: Tangent, Oregon

NW $\frac{1}{4}$ SE $\frac{1}{4}$ Sec. 25 T. 11 S., R. 4 W., W.M.

Bearing and distance from section or subdivision
corner N. 10° E. 34.24 chs. from SW cor. SE $\frac{1}{4}$ Sec. 25

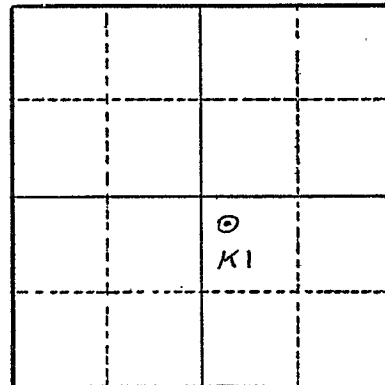

Section 25

Altitude at well 225 ft. Interpolated

TYPE OF WELL: drilled Date Constructed 7/12/51

Depth drilled 53 ft. Depth cased 53 ft.

CASING RECORD: 6 inch steel casing set from 0 to 53 ft.

FINISH: Slit perforations set from 43 to 53 ft.

AQUIFERS: unknown

WATER LEVEL: 15 ft. below land surface

PUMPING EQUIPMENT: Type Fairbanks Morse 1 $\frac{1}{2}$ " centrifugal H.P. 3
Capacity 100 G.P.M.

WELL TESTS:
Drawdown 5 ft. after _____ hours pumping 100 G.P.M.
Drawdown _____ ft. after _____ hours _____ G.P.M.

USE OF WATER Irrigation 15 acres Temp. _____ °F. _____, 19____

SOURCE OF INFORMATION Reg. St. GR-309

DRILLER or DIGGER T. J. Burkhart; 169 N. 1st W., Tremonton, Utah

ADDITIONAL DATA:
Log _____ Water Level Measurements _____ Chemical Analysis _____ Aquifer Test _____

REMARKS: