

STATE ENGINEER  
Salem, Oregon

LINN  
8564

# Well Record

STATE WELL NO. 11/LW-26H(1)  
COUNTY Linn  
APPLICATION NO. GR-118

OWNER: R. G. & Eola L. Allen


MAILING ADDRESS: Rt. 1

LOCATION OF WELL: Owner's No. 1

CITY AND STATE: Tangent, Oregon

SE 1/4 NE 1/4 Sec. 26 T. 11 S., R. 4 W., W.M.

Bearing and distance from section or subdivision  
corner S. 12° 15' W. 8.75 chs. from SE cor. Geo. H.  
Hughes DLC 78

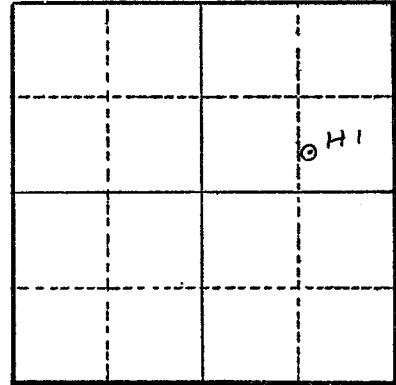

Altitude at well 215 ft. Interpolated

TYPE OF WELL: drilled Date Constructed 6/11/52

Depth drilled 58 ft. Depth cased 58 ft.

Section 26

CASING RECORD: 8 inch steel casing set from 0 to 58 ft.

FINISH: Slit perforations set from 35 to 58 ft.

AQUIFERS:

WATER LEVEL:

PUMPING EQUIPMENT: Type Fairbanks Morse deep well turbine H.P. 5  
Capacity 100 G.P.M.

WELL TESTS:  
Drawdown 55 ft. after 60 hours G.P.M.  
Drawdown ft. after hours G.P.M.

USE OF WATER irrigation 11 acres Temp. °F., 19

SOURCE OF INFORMATION Reg. St. GR-118

DRILLER or DIGGER T. J. Burkhart; 169 N. 1st W., Tremonton, Utah

ADDITIONAL DATA:

Log Water Level Measurements Chemical Analysis Aquifer Test

REMARKS: