

STATE ENGINEER  
Salem, Oregon

LINN  
8565

# Well Record


STATE WELL NO. 11/4W-26K  
COUNTY Linn  
APPLICATION NO. CR-3604

OWNER: Samuel F. Walters MAILING ADDRESS: Route 1

LOCATION OF WELL: Owner's No. CITY AND STATE: Tangent, Oregon

NW 1/4 SE 1/4 Sec. 26 T. 11 S., R. 4 W., W.M.

Bearing and distance from section or subdivision corner 400 ft. S. and 833 ft. W. of the SE cor. Hughes D.L.C.

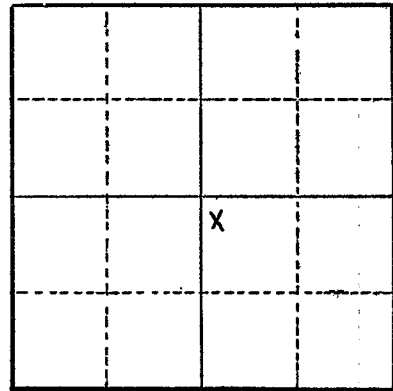

Section 26

Altitude at well \_\_\_\_\_

TYPE OF WELL: Drilled Date Constructed \_\_\_\_\_

Depth drilled 45 ft. Depth cased 45 ft.

### CASING RECORD:

6 inch casing set to 45 feet

### FINISH:

### AQUIFERS:

### WATER LEVEL:

5 feet below surface

PUMPING EQUIPMENT: Type Homart Jet H.P. 1  
Capacity 20 G.P.M.

### WELL TESTS:

Drawdown \_\_\_\_\_ ft. after \_\_\_\_\_ hours \_\_\_\_\_ G.P.M.  
Drawdown \_\_\_\_\_ ft. after \_\_\_\_\_ hours \_\_\_\_\_ G.P.M.

USE OF WATER Irrigation Temp. \_\_\_\_\_ °F. \_\_\_\_\_, 19\_\_\_\_

SOURCE OF INFORMATION Well Registration Statement

DRILLER or DIGGER \_\_\_\_\_

### ADDITIONAL DATA:

Log \_\_\_\_\_ Water Level Measurements \_\_\_\_\_ Chemical Analysis \_\_\_\_\_ Aquifer Test \_\_\_\_\_

### REMARKS: