

STATE ENGINEER
Salem, Oregon

LINN Well Record
8567


STATE WELL NO. 11/4W - 26N
COUNTY LINN
APPLICATION NO. GR-2243

OWNER: James J. and Jessie Alma Horning MAILING ADDRESS: Route 3, Box 879

LOCATION OF WELL: Owner's No. _____ CITY AND STATE: Albany, Oregon

SW $\frac{1}{4}$ SW $\frac{1}{4}$ Sec. 26 T. 11 N. 4 E.
S., R. W., W.M.

Bearing and distance from section or subdivision corner 82 $\frac{1}{2}$ ' N. and 858' E.

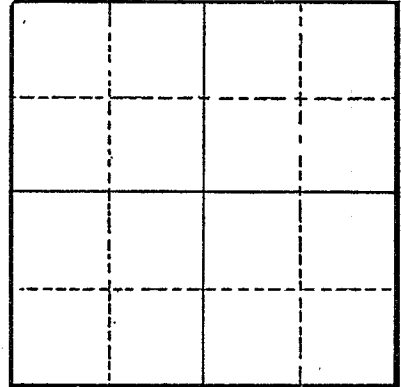

Section _____

Altitude at well _____

TYPE OF WELL: Drilled Date Constructed 1952

Depth drilled 50 Depth cased 50

CASING RECORD:

8-Inch

FINISH:

Perforations from 18 to 50

AQUIFERS:

WATER LEVEL:

18-Feet

PUMPING EQUIPMENT: Type Advanced Jet H.P. 1
Capacity 50 G.P.M.

WELL TESTS:

Drawdown 36 ft. after _____ hours Pumping 100 G.P.M.
Drawdown _____ ft. after _____ hours _____ G.P.M.

USE OF WATER Irrigation Temp. _____ °F. _____, 19____

SOURCE OF INFORMATION GR-2144
DRILLER or DIGGER Bill Hamilton Drilling Company, 838 E. Third Avenue, Albany Oregon

ADDITIONAL DATA:
Log _____ Water Level Measurements _____ Chemical Analysis _____ Aquifer Test _____

REMARKS: