

STATE ENGINEER
Salem, Oregon

LINN
8619

Well Record

STATE WELL NO. 11/1W-28M
COUNTY LINN
APPLICATION NO. GR-2860

OWNER: Lyle Truax


MAILING ADDRESS: 104-G Clark Co. Courthouse

LOCATION OF WELL: Owner's No. #3

CITY AND STATE: Vancouver, Washington

NW 1/4 SW 1/4 Sec. 28 T. 11 N. S. R. 4 W., W.M.

Bearing and distance from section or subdivision corner S. 67° 15' E. 17.2 chains

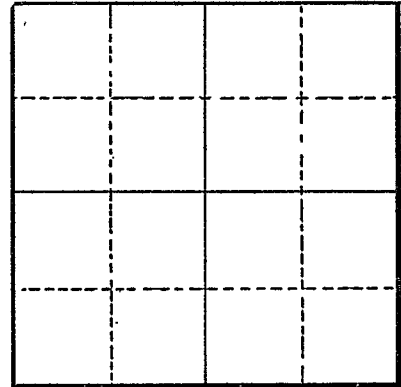

Section

Altitude at well

TYPE OF WELL: drilled Date Constructed 1948

Depth drilled 25 Depth cased 25

CASING RECORD:

12-inch

FINISH:

Slot perforations from 15 to 25

AQUIFERS:

WATER LEVEL:

12-feet

PUMPING EQUIPMENT: Type Gardner Denver 3" Centrifugal H.P. 30
Capacity 500 G.P.M.

WELL TESTS:

Drawdown ft. after hours G.P.M.
Drawdown ft. after hours G.P.M.

USE OF WATER Irrigation Temp. °F. 19

SOURCE OF INFORMATION GR-2694

DRILLER or DIGGER Sloper

ADDITIONAL DATA:

Log Water Level Measurements Chemical Analysis Aquifer Test

REMARKS: